

Date: Monday, 3/6/2006 1:52:29 PM
 User: Kim Johnston

Process Sheet

Customer : CU-DAR001 Dart Helicopters Services Drawing Name : SPACEPOD ASSEMBLY RH
 Job Number : 26065
 Estimate Number : 10799
 P.O. Number : N/A Part Number : D350600142
 This Issue : 3/6/2006 S.O. No. : N/A Drawing Number : D3188 REV A4 P/ICA-D350-600
 Prsht Rev. : NC Project Number : N/A
 First Issue : N/A Type : SMALL /MED FAB Drawing Revision : A4 P/2 06-03-07
 Previous Run : 26064 Material : N/A
 Written By : See Comment Below Due Date : 3/31/2006 Qty: 1 Um: Each
 Checked & Approved By : 06.03.06
 Comment : Est Rev:D 06.04.14 Incorporated procedures from D3187-1/-2 K J/JLM

Additional Product

Job Number:



Seq. #: Machine Or Operation: Description :

1.0 DC DOCUMENT CONTROL



Comment: DOCUMENT CONTROL

Photocopy bluefile and type labels as per PPP D350-600-142 CHG002

KS 06 03. 07 ①

2.0 26065A SPACEPOD BODY RH



Comment: Sub-Component SPACEPOD BODY RH ✓

3.0 26065B SPACEPOD DOOR RH



Comment: Sub-Component SPACEPOD DOOR RH ✓

4.0 D31872 Spacepod Floor



Comment: Qty.: 1.0000 Each(s)/Unit Total: 1.0000 Each(s)

Pick:

Qty	Part Number	Description	Batch
1	D3187-2	Floor	B 25405
1	D3186-2	DOOR (REF)	26065B
1	D3188-2	BODY (REF)	26065A

5.0 ALS41032130 Insert



Comment: Qty.: 28.0000 Each(s)/Unit Total: 28.0000 Each(s)

Pick:

Qty	Part Number	Description	Batch
28	ALS4-1032-130	Insert	M18293

W/O:		WORK ORDER CHANGES						
DATE	STEP	PROCEDURE CHANGE		By	Date	Qty	Approval Chief Eng / Prod Mgr	Approval QC Inspector

Part No: _____ PAR #: _____ Fault Category: _____ NCR: Yes No DQA: _____ Date: _____

QA: N/C Closed: _____ Date: _____

NCR:		WORK ORDER NON-CONFORMANCE (NCR)							
DATE	STEP	Description of NC Section A	Corrective Action		Section B		Verification Section C	Approval Chief Eng	Approval QC Inspector
			Initial Chief Eng	Action Description Chief Eng	Sign & Date				

NOTE: Date & initial all entries

Date: Monday, 3/6/2006 1:52:30 PM
User: Kim Johnston

Process Sheet

Customer: CU-DAR001 Dart Helicopters Services

Drawing Name: SPACEPOD ASSEMBLY RH

Job Number: 26065

Part Number: D350600142

Job Number:



Seq. #:

Machine Or Operation:

Description :

6.0

SMALL FAB 1

SMALL & MEDIUM FAB RESOURCE 1



Comment: SMALL & MEDIUM FAB RESOURCE 1

1-Transfer drill (#30) from D3187-2. Open holes in floor to Ø0.297". Install inserts as per Dwg D3188.

ml 06/07/24

7.0

QC5

INSPECT WORK TO CURRENT STEP



Comment: INSPECT WORK TO CURRENT STEP

8.0

SMALL FAB 1

SMALL & MEDIUM FAB RESOURCE 1



Comment: SMALL & MEDIUM FAB RESOURCE 1

1-Open holes in D3187-2 as per Dwg 3187

2-Deburr D3187-2

ml 06/07/24

9.0

QC5

INSPECT WORK TO CURRENT STEP



Comment: INSPECT WORK TO CURRENT STEP

10.0

HAND FINISHING1

HAND FINISHING RESOURCE #1



Comment: HAND FINISHING RESOURCE #1

Chemical Conversion Coat as per QSI 005 4.1

SC 06/07/31

①

11.0

POWDER COATING

POWDER COATING



Comment: POWDER COATING

Powder Coat Black Sandtex (Ref: 4.3.5.7) as per QSI 005 4.3

SC 06/07/31

①

12.0

QC3

INSPECT POWDER COAT/CHEMICAL CONVERSION



Comment: INSPECT POWDER COAT/CHEMICAL CONVERSION

FC 06 07 31 ①

13.0

D2986

Black Neoprene foam .125



Comment: Qty.: 5.9010 sf(s)/Unit Total : 5.9010 sf(s)

Pick:


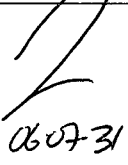
Qty Part Number

Description

Batch

B 24628

✓

W/O:		WORK ORDER CHANGES						
DATE	STEP	PROCEDURE CHANGE	By	Date	Qty	Approval Chief Eng / Prod Mgr	Approval QC Inspector	
06-07-31	7.0	QCS At step 7.0 not req'd remove and keep at step 9.0. perm. change. 					 06-07-31	

Part No: _____ PAR #: _____ Fault Category: _____ NCR: Yes No DQA: _____ Date: _____

QA: N/C Closed: _____ Date: _____

NCR:		WORK ORDER NON-CONFORMANCE (NCR)							
DATE	STEP	Description of NC Section A	Corrective Action		Section B		Verification Section C	Approval Chief Eng	Approval QC Inspector
			Initial Chief Eng	Action Description Chief Eng	Sign & Date				

NOTE: Date & initial all entries

Date: Monday, 3/6/2006 1:52:30 PM
User: Kim Johnston

Process Sheet

Customer: CU-DAR001 Dart Helicopters Services

Drawing Name: SPACEPOD ASSEMBLY RH

Job Number: 26065

Part Number: D350600142

Job Number:



Seq. #:

Machine Or Operation:

Description :

5.62SF D2986 Neoprene Foam B24628

14.0

SMALL FAB 1

SMALL & MEDIUM FAB RESOURCE 1



Comment: SMALL & MEDIUM FAB RESOURCE 1

1-Cut D2986 Neoprene Foam per template D2986T1

mlf
2006/07/24

2-Attach Neoprene Foam using Contact Cement

A/R Contact Cement

Batch:

M16199

SAD

06:08:15

Q

15.0

QC5

INSPECT WORK TO CURRENT STEP



Comment: INSPECT WORK TO CURRENT STEP

0608-16 Q

16.0

D2179

Doubler



Comment: Qty.: 2.0000 Each(s)/Unit Total: 2.0000 Each(s)

Pick:

Qty Part Number Description Batch

2 D2179 Hinge Bracket Plate

B26077

17.0

D2219

Door Prop Doubler



Comment: Qty.: 1.0000 Each(s)/Unit Total: 1.0000 Each(s)

Pick:

Qty Part Number Description Batch

1 D2219 Door Support Bracket

B14027

18.0

D2228

Backing Plate



Comment: Qty.: 2.0000 Each(s)/Unit Total: 2.0000 Each(s)

Pick:

Qty Part Number Description Batch

2 D2228 Backing Plate

B24560

19.0

D2237

Striker Plate



Comment: Qty.: 3.0000 Each(s)/Unit Total: 3.0000 Each(s)

Pick:

Qty Part Number Description Batch

3 D2237 Strike Plate

B25327

W/O:		WORK ORDER CHANGES						
DATE	STEP	PROCEDURE CHANGE		By	Date	Qty	Approval Chief Eng / Prod Mgr	Approval QC Inspector

Part No: _____ PAR #: _____ Fault Category: _____ NCR: Yes No DQA: _____ Date: _____

QA: N/C Closed: _____ Date: _____

NCR:		WORK ORDER NON-CONFORMANCE (NCR)							
DATE	STEP	Description of NC Section A	Corrective Action		Section B		Verification Section C	Approval Chief Eng	Approval QC Inspector
			Initial Chief Eng	Action Description Chief Eng	Sign & Date				

NOTE: Date & initial all entries

Date: Monday, 3/6/2006 1:52:30 PM
User: Kim Johnston

Process Sheet

Customer: CU-DAR001 Dart Helicopters Services

Drawing Name: SPACEPOD ASSEMBLY RH

Job Number: 26065

Part Number: D350600142

Job Number:



Seq. #:

Machine Or Operation:

Description :

20.0

D2464

3/4 Seal



Comment: Qty.: 10.9305 f(s)/Unit Total : 10.9305 f(s)

Pick:

Qty Part Number Description Batch

1 D2464-125" neoprene Seal B25153

21.0

D2586

Door Latch



Comment: Qty.: 3.0000 Each(s)/Unit Total : 3.0000 Each(s)

Pick:

Qty Part Number Description Batch

3 D2586 Latch B26079

22.0

D2588

Bracket

mounting channel



Comment: Qty.: 1.0000 Each(s)/Unit Total : 1.0000 Each(s)

Pick:

Qty Part Number Description Batch

3 D2586 Latch 1x D2588 B21509

23.0

D2589

Keys, Key Chain



Comment: Qty.: 1.0000 Each(s)/Unit Total : 1.0000 Each(s)

Pick:

Qty Part Number Description Batch

1 D2588 Mounting Channel 1x D2589 B26031

24.0

D2621

Latch Plate



Comment: Qty.: 3.0000 Each(s)/Unit Total : 3.0000 Each(s)

Pick:

Qty Part Number Description Batch

3 D2621 Latch Plate B25474

25.0

D28571

Hinge Bracket



Comment: Qty.: 1.0000 Each(s)/Unit Total : 1.0000 Each(s)

Pick:

Qty Part Number Description Batch

1 D2857-1 Hinge Bracket B26501

These are mixed

W/O:		WORK ORDER CHANGES						
DATE	STEP	PROCEDURE CHANGE		By	Date	Qty	Approval Chief Eng / Prod Mgr	Approval QC Inspector

Part No: _____ PAR #: _____ Fault Category: _____ NCR: Yes No DQA: _____ Date: _____

QA: N/C Closed: _____ Date: _____

NCR:		WORK ORDER NON-CONFORMANCE (NCR)							
DATE	STEP	Description of NC Section A	Corrective Action		Section B		Verification Section C	Approval Chief Eng	Approval QC Inspector
			Initial Chief Eng	Action Description Chief Eng	Sign & Date				

NOTE: Date & initial all entries

Date: Monday, 3/6/2006 1:52:30 PM
User: Kim Johnston

Process Sheet

Customer: CU-DAR001 Dart Helicopters Services

Drawing Name: SPACEPOD ASSEMBLY RH

Job Number: 26065

Part Number: D350600142

Job Number:



Seq. #:

Machine Or Operation:

Description :

26.0

D28572

Hinge Bracket



Comment: Qty.: 1.0000 Each(s)/Unit Total : 1.0000 Each(s)

Pick:

Qty Part Number Description Batch

1 D2857-2 Hinge Bracket B26034

27.0

D2977

Hinge Bracket



Comment: Qty.: 2.0000 Each(s)/Unit Total : 2.0000 Each(s)

Pick:

Qty Part Number Description Batch

2 D2977 Hinge Bracket B14106

28.0

D2978

Hinge Bracket



Comment: Qty.: 2.0000 Each(s)/Unit Total : 2.0000 Each(s)

Pick:

Qty Part Number Description Batch

2 D2978 Hinge Bracket B14107

29.0

D2982041

Prop Arm Assembly



Comment: Qty.: 1.0000 Each(s)/Unit Total : 1.0000 Each(s)

Pick:

Qty Part Number Description Batch

1 D2982-041 Prop Arm Assembly 27507

30.0

D30153

Lock Nut



Comment: Qty.: 1.0000 Each(s)/Unit Total : 1.0000 Each(s)

Pick:

Qty Part Number Description Batch

1 D3015-3 Lock Nut B22365

31.0

A3235020935

Washer - Countersunk



Comment: Qty.: 8.0000 Each(s)/Unit Total : 8.0000 Each(s)

Pick:

Qty Part Number Description Batch

8 A3235-020-935 Washer M100477

W/O:		WORK ORDER CHANGES							
DATE	STEP	PROCEDURE CHANGE		By	Date	Qty	Approval Chief Eng / Prod Mgr	Approval QC Inspector	

Part No: _____ PAR #: _____ Fault Category: _____ NCR: Yes No DQA: _____ Date: _____

QA: N/C Closed: _____ Date: _____

NCR:		WORK ORDER NON-CONFORMANCE (NCR)							
DATE	STEP	Description of NC Section A	Corrective Action		Section B		Verification Section C	Approval Chief Eng	Approval QC Inspector
			Initial Chief Eng	Action Description Chief Eng		Sign & Date			

NOTE: Date & initial all entries

Date: Monday, 3/6/2006 1:52:30 PM
User: Kim Johnston

Process Sheet

Customer: CU-DAR001 Dart Helicopters Services

Drawing Name: SPACEPOD ASSEMBLY RH

Job Number: 26065

Part Number: D350600142

Job Number:



Seq. #:

Machine Or Operation:

Description :

32.0

AN526C832R9

Screw



Comment: Qty.: 12.0000 Each(s)/Unit Total : 12.0000 Each(s)

Pick:

Qty Part Number Description Batch

12 AN526C832R9 Screw M100447

✓

33.0

AN960JD10

Washer



Comment: Qty.: 3.0000 Each(s)/Unit Total : 3.0000 Each(s)

Pick:

Qty Part Number Description Batch

3 AN960JD10 Washer M100743

✓

34.0

AN960JD516

Washer



Comment: Qty.: 1.0000 Each(s)/Unit Total : 1.0000 Each(s)

Pick:

Qty Part Number Description Batch

1 AN960JD516 Washer M15927

✓

35.0

AN960JD8

Washer



Comment: Qty.: 16.0000 Each(s)/Unit Total : 16.0000 Each(s)

Pick:

Qty Part Number Description Batch

16 AN960JD8 Washer M11989

✓

36.0

AN960JD8L

Washer



Comment: Qty.: 4.0000 Each(s)/Unit Total : 4.0000 Each(s)

Pick:

Qty Part Number Description Batch

4 AN960JD8L Washer M6956

✓

Qty 2 Rivets

MS 20426-AD4-6

B/N# M2566

✓

okay
per 3/6/06
26065

↓
missing
↑

W/O:		WORK ORDER CHANGES							
DATE	STEP	PROCEDURE CHANGE		By	Date	Qty	Approval Chief Eng / Prod Mgr	Approval QC Inspector	

Part No: _____ PAR #: _____ Fault Category: _____ NCR: Yes No DQA: _____ Date: _____

QA: N/C Closed: _____ Date: _____

NCR:		WORK ORDER NON-CONFORMANCE (NCR)							
DATE	STEP	Description of NC Section A	Corrective Action		Section B		Verification Section C	Approval Chief Eng	Approval QC Inspector
			Initial Chief Eng	Action Description Chief Eng		Sign & Date			

NOTE: Date & initial all entries

Date: Monday, 3/6/2006 1:52:30 PM
User: Kim Johnston

Process Sheet

Customer: CU-DAR001 Dart Helicopters Services

Drawing Name: SPACEPOD ASSEMBLY RH

Job Number: 26065

Part Number: D350600142

Job Number:



Seq. #:

Machine Or Operation:

Description :

37.0

MS20426AD45

Rivet



Comment: Qty.: 6.0000 Each(s)/Unit Total : 6.0000 Each(s)

Pick:

Qty Part Number Description Batc

6 MS20426AD4-5 Rivet M3459

38.0

MS21042L08

Nut



Comment: Qty.: 14.0000 Each(s)/Unit Total : 14.0000 Each(s)

Pick:

Qty Part Number Description Batch

14 MS21042L08 Nut (or -8) M100564

39.0

MS21042L3

Nut



Comment: Qty.: 3.0000 Each(s)/Unit Total : 3.0000 Each(s)

Pick:

Qty Part Number Description Batch

3 MS21042L3 Nut (or -3) M15539

40.0

MS270390810

Screw



Comment: Qty.: 2.0000 Each(s)/Unit Total : 2.0000 Each(s)

Pick:

Qty Part Number Description Batch

2 MS27039-0810 Screw M5865

41.0

MS27039125

Screw



Comment: Qty.: 3.0000 Each(s)/Unit Total : 3.0000 Each(s)

Pick:

Qty Part Number Description Batch

3 MS27039-1-25 Screw M17570

42.0

SL69BS

Ball Stud



Comment: Qty.: 1.0000 Each(s)/Unit Total : 1.0000 Each(s)

Pick:

Qty Part Number Description Batch

1 SL69-BS Ball Stud M16948

W/O:		WORK ORDER CHANGES						
DATE	STEP	PROCEDURE CHANGE		By	Date	Qty	Approval Chief Eng / Prod Mgr	Approval QC Inspector

Part No: _____ PAR #: _____ Fault Category: _____ NCR: Yes No DQA: _____ Date: _____

QA: N/C Closed: _____ Date: _____

NCR:		WORK ORDER NON-CONFORMANCE (NCR)							
DATE	STEP	Description of NC Section A	Corrective Action		Section B		Verification Section C	Approval Chief Eng	Approval QC Inspector
			Initial Chief Eng	Action Description Chief Eng		Sign & Date			

NOTE: Date & initial all entries

Date: Monday, 3/6/2006 1:52:31 PM
User: Kim Johnston

Process Sheet

Customer: CU-DAR001 Dart Helicopters Services

Drawing Name: SPACEPOD ASSEMBLY RH

Job Number: 26065

Part Number: D350600142

Job Number:



Seq. #:

Machine Or Operation:

Description :

43.0

SMALL FAB 1

SMALL & MEDIUM FAB RESOURCE 1



Comment: SMALL & MEDIUM FAB RESOURCE 1

Assemble D3186-2 door with D3188-2 body as per Dwg ICA-D350-600

PTO
ml 24/01/06

44.0

HAND FINISHING1

HAND FINISHING RESOURCE #1



Comment: HAND FINISHING RESOURCE #1

Wing Walk Spacepod top surface of Pod as per Dwg D3188-2 & QSI 005 4.4

Batch: m/01667

FC 060731 ①

45.0

QC3

INSPECT POWDER COAT/CHEMICAL CONVERSION



Comment: Inspect Wing Walk

06-08-01 ①

46.0

K10018

Spacepod Hardware Kit



Comment: Qty.: 1.0000 Each(s)/Unit Total : 1.0000 Each(s)

Pick: Packing Kit

Qty Part Number

Description

Batch

1 K10018

Spacepod Hardware Kit

B27849
B26065

1 D3187-2(Ref)

Spacepod Floor

47.0

QC4

INSPECT 100% KITS FOR COMPLETENESS



Comment: INSPECT 100% KITS FOR COMPLETENESS

C 06/08/17 ①

48.0

PACKAGING 1

PACKAGING RESOURCE #1



Comment: PACKAGING RESOURCE #1

Identify and pack for shipping as per PPP D350-600-142

Location:

PPP Rev: C

B 06/08/17 ①

49.0

DC

DOCUMENT CONTROL



Comment: DOCUMENT CONTROL

Inspection Level 21

06.08.22

Job Completion




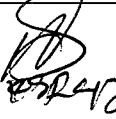



u 06/08/18

Dart Aerospace Ltd

W/O:		WORK ORDER CHANGES							
DATE	STEP	PROCEDURE CHANGE		By	Date	Qty	Approval Chief Eng / Prod Mgr	Approval QC Inspector	
06-07-31	43.1	Add QCS. Permanent change					N/A		
		QCS done by			06-07-31	1			

Part No: D350-600-142 PAR #: N/A Fault Category: Supplier NCR: Yes No DQA: 1 Date: 06.08.21
QA: N/C Closed: 1 Date: 06.08.21

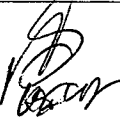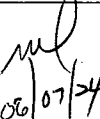NCR:		WORK ORDER NON-CONFORMANCE (NCR)							
DATE	STEP	Description of NC Section A	Corrective Action		Section B		Verification Section C	Approval Chief Eng	Approval QC Inspector
			Initial Chief Eng	Action Description Chief Eng	Sign & Date				
24 July 2006	43	The door do not fit with the body		Cut about .100 around the inside body. Grind 2 corners of the door. Fix with glue + Re-prime	 06/07/24	 06-07-31	 06-07-24	 06-07-24	

NOTE: Date & initial all entries



DESIGN JB	DRAWN BY <i>CP</i>	DART AEROSPACE LTD HAWKESBURY, ONTARIO, CANADA	
CHECKED <i>[Signature]</i>	APPROVED <i>[Signature]</i>	DRAWING NO. D3188	REV. A SHEET 1 OF 7
DATE 03.04.03		TITLE SPACEPOD BODY	SCALE NTS
A	03.04.03	NEW ISSUE	

RELEASED
#0304.22

GENERAL NOTES:

1. REFERENCE DIMENSIONS MATCH AIRCRAFT CONTOUR AND DOOR OPENING
2. LAMINATE PER DART QSI 006. LAMINATION SCHEDULE PER THIS DRAWING
3. MATERIALS:

RESIN: EPOCAST 50-A/9816 OR DERAKANE 470-36/411/510A40

FIBER: 9.7 oz 7781 WEAVE "S" GLASS (9 oz SATIN)
12 oz UNIDIRECTIONAL FIBERGLASS ("12 OZ UNIDIRECTIONAL")
18 oz ROVING "E" GLASS (18 oz CLOTH)
OWENS CORNING MILLED FIBERS, "E" GLASS
3M K20 GLASS BUBBLES

FOAM: A500 CORE CELL
OR DIVINYCELL
OR AIREX
OR KLEGECELL
FILL VOIDS IN FOAM WITH PASTE MADE FROM MILLED FIBERS & RESIN

4. MOLD SCHEDULE:

<u>PART</u>	<u>LAYUP</u>	<u>TRIM AND DRILL</u>
D3188-1	DT8003	DT8501
D3188-2	DT8004	DT8502
D3188-3	DT8500	DT8501

5. APPLY ANTI-SKID PAINT TO TOP SURFACE OF PODS PER QSI 005 4.4
6. FINISH: INSIDE/OUTSIDE WITH GREY DUPONT HIGHBUILD PRIMER 1144-S

SHOP COPY
RETURN TO
ENGINEERING
UNCONTROLLED COPY
SUBJECT TO AMENDMENT
WITHOUT NOTICE
WORK ORDER
NO. *26065*








Copyright © 2003 by DART AEROSPACE LTD

THIS DOCUMENT IS PRIVATE AND CONFIDENTIAL AND IS SUPPLIED ON THE EXPRESS CONDITION THAT IT IS NOT TO BE USED FOR ANY PURPOSE OR COPIED OR COMMUNICATED TO ANY OTHER PERSON WITHOUT WRITTEN PERMISSION FROM DART AEROSPACE LTD.



DESIGN JB	DRAWN BY <i>CP</i>	DART AEROSPACE LTD HAWKESBURY, ONTARIO, CANADA	
CHECKED <i>[Signature]</i>	APPROVED <i>[Signature]</i>	DRAWING NO. D3188	REV. A SHEET 2 OF 7
DATE 03.04.03		TITLE SPACEPOD BODY	SCALE NTS

RELEASED
03.04.22

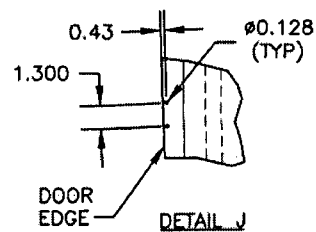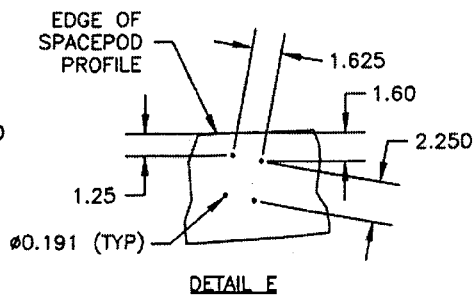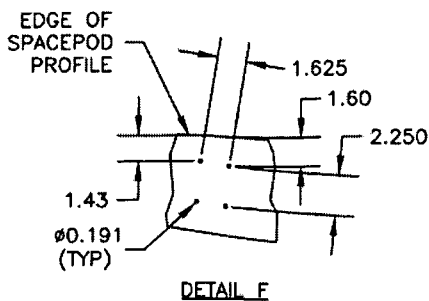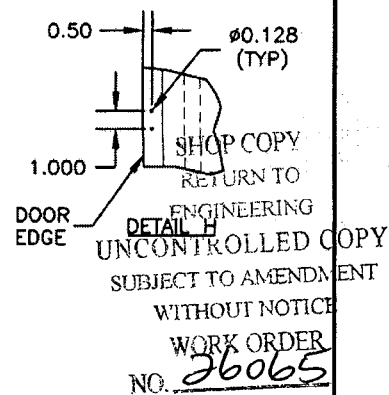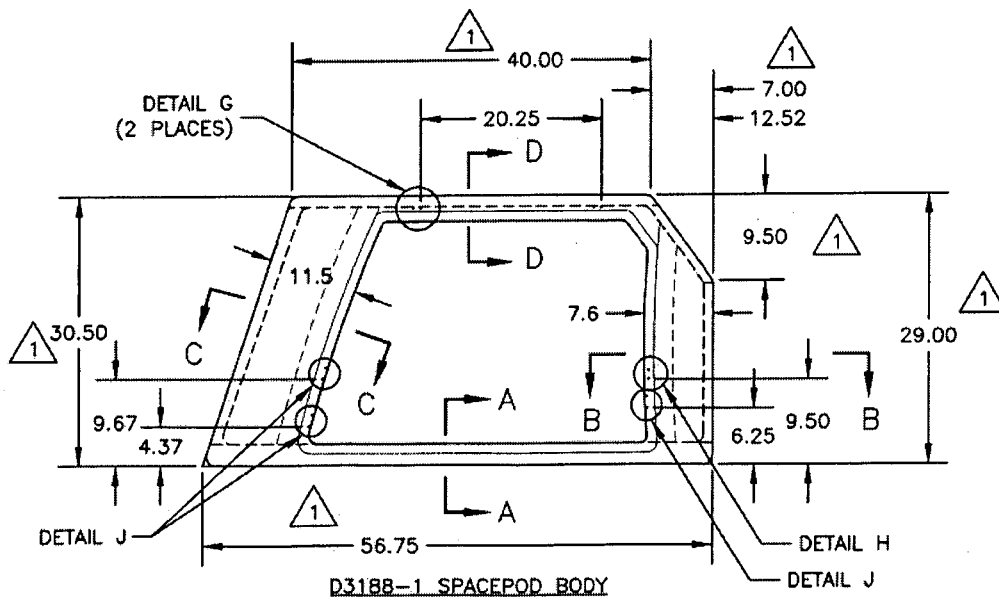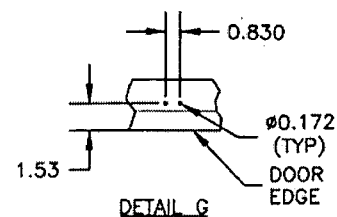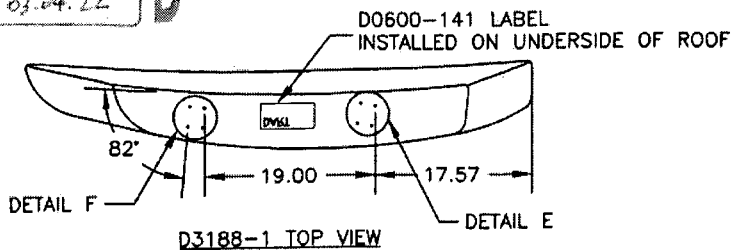


Copyright © 2003 by DART AEROSPACE LTD

THIS DOCUMENT IS PRIVATE AND CONFIDENTIAL AND IS SUPPLIED ON THE EXPRESS CONDITION THAT IT IS NOT TO BE USED FOR ANY PURPOSE OR COPIED, OR COMMUNICATED TO ANY OTHER PERSON WITHOUT WRITTEN PERMISSION FROM DART AEROSPACE LTD.





DESIGN JB	DRAWN BY <i>JP</i>	DART AEROSPACE LTD HAWKESBURY, ONTARIO, CANADA	
CHECKED <i>[Signature]</i>	APPROVED <i>[Signature]</i>	DRAWING NO. D3188	REV. A SHEET 3 OF 7
DATE 03.04.03	TITLE SPACEPOD BODY		SCALE NTS





RELEASED
03.04.22

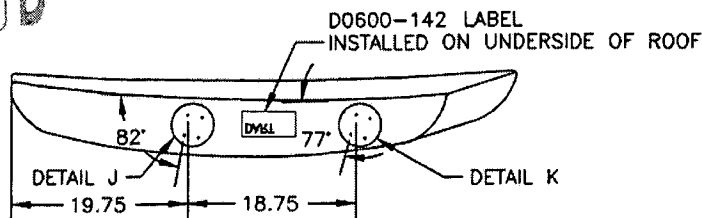

D3188-2 TOP VIEW

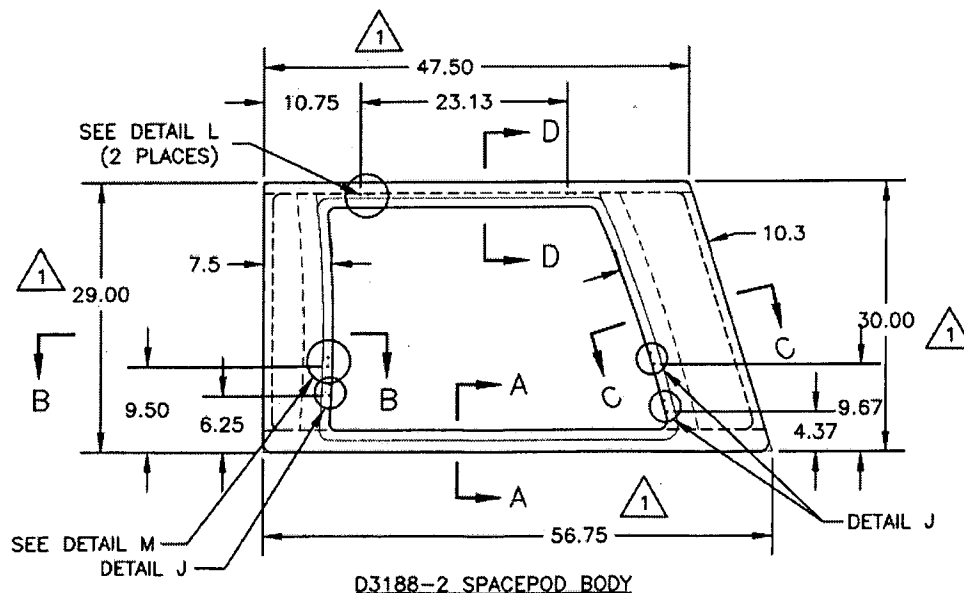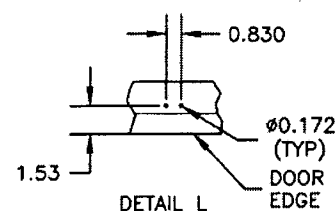

D3188-2 SPACEPOD BODY

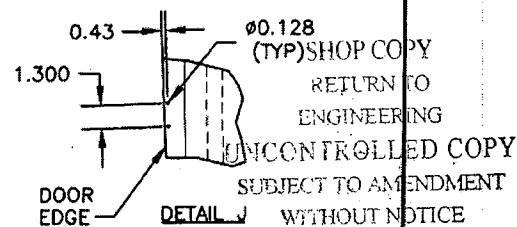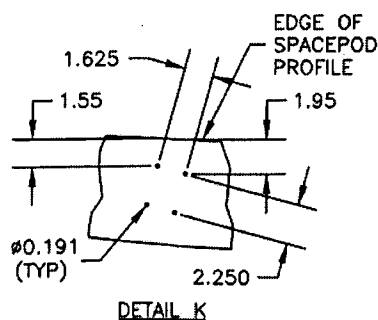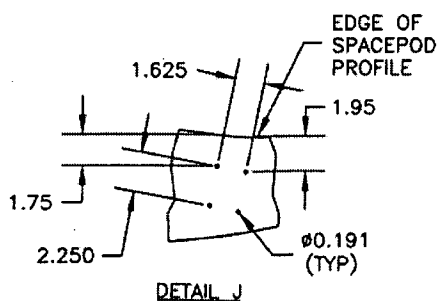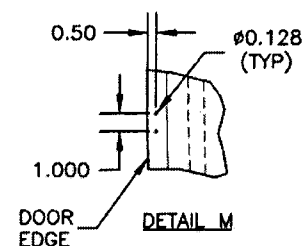

WORK ORDER
26065








Copyright © 2003 by DART AEROSPACE LTD

THIS DOCUMENT IS PRIVATE AND CONFIDENTIAL AND IS SUPPLIED ON THE EXPRESS CONDITION THAT IT IS NOT TO BE USED FOR ANY PURPOSE OR COPIED OR COMMUNICATED TO ANY OTHER PERSON WITHOUT WRITTEN PERMISSION FROM DART AEROSPACE LTD.



DESIGN JB	DRAWN BY <i>JP</i>	DART AEROSPACE LTD HAWKESBURY, ONTARIO, CANADA	
CHECKED <i>[Signature]</i>	APPROVED <i>[Signature]</i>	DRAWING NO. D3188	REV. A SHEET 4 OF 7
DATE 03.04.03	TITLE SPACEPOD BODY		SCALE NTS

RELEASED
03.04.22

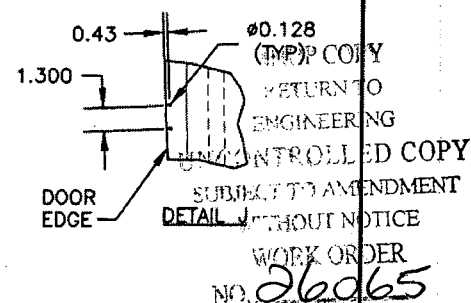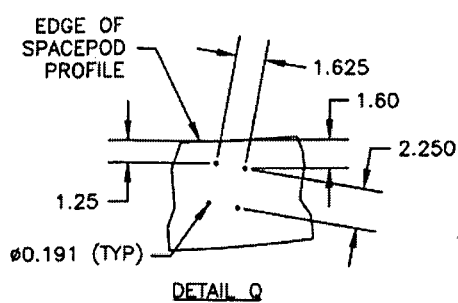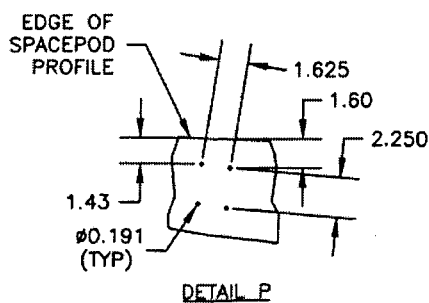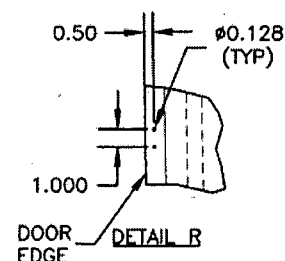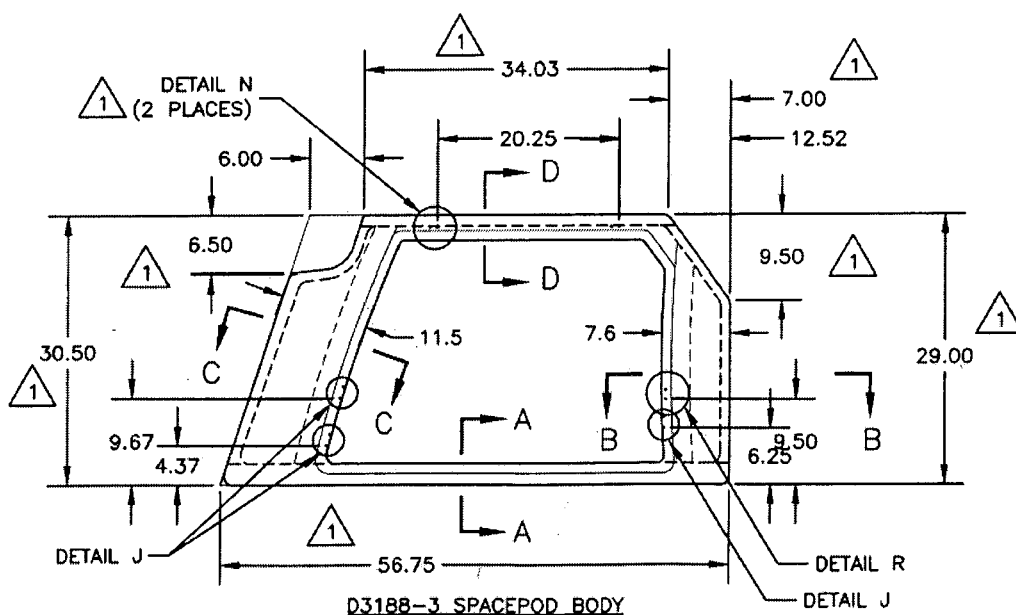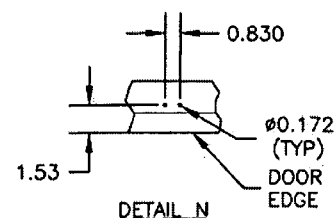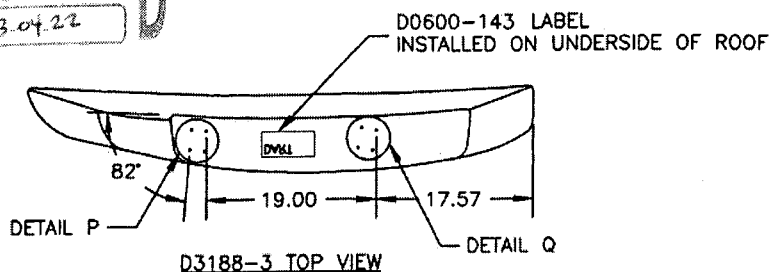


Copyright © 2003 by DART AEROSPACE LTD

THIS DOCUMENT IS PRIVATE AND CONFIDENTIAL AND IS SUPPLIED ON THE EXPRESS CONDITION THAT IT IS NOT TO BE USED FOR ANY PURPOSE OR COPIED OR COMMUNICATED TO ANY OTHER PERSON WITHOUT WRITTEN PERMISSION FROM DART AEROSPACE LTD.



DESIGN JB	DRAWN BY <i>CP</i>	DART AEROSPACE LTD HAWKESBURY, ONTARIO, CANADA	
CHECKED <i>H</i>	APPROVED <i>S</i>	DRAWING NO. D3188	REV. A SHEET 5 OF 7
DATE 03.04.03		TITLE SPACEPOD BODY	SCALE NTS

RELEASED
03.04.22

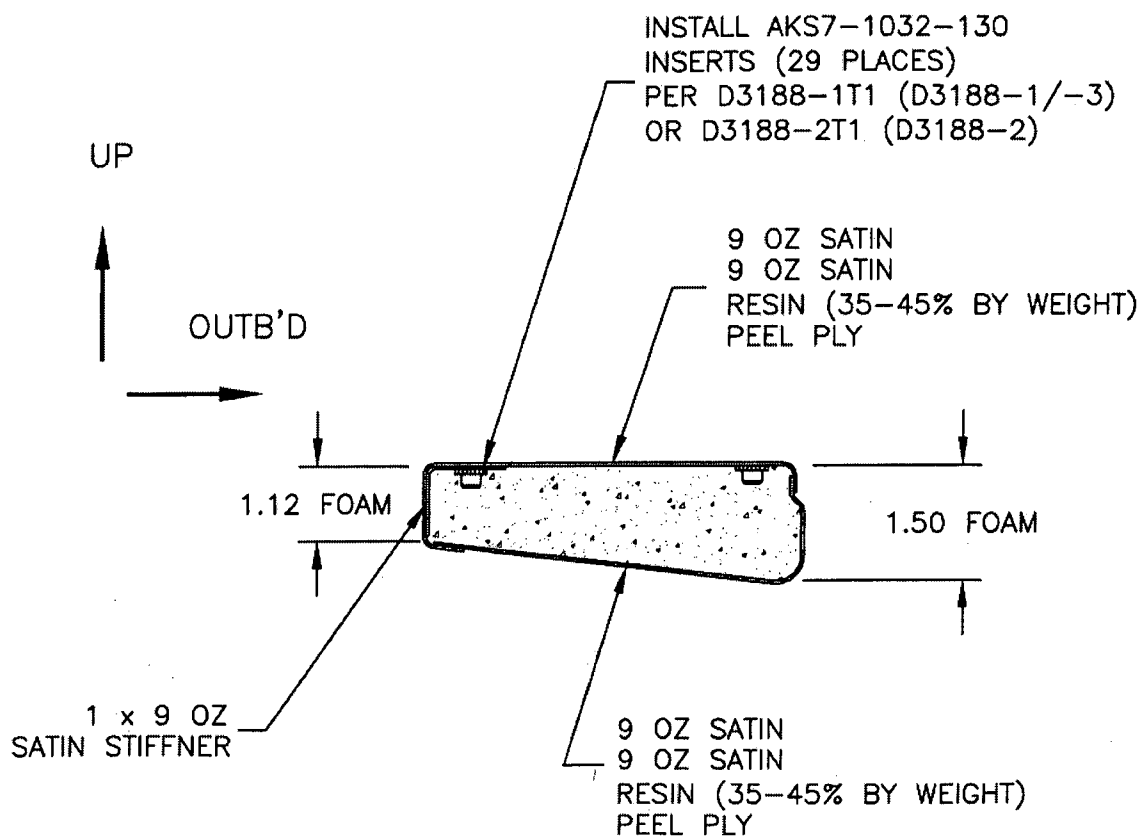

SECTION A-A
(TYPICAL FLOOR SECTION)

SHOP COPY
RETURN TO
ENGINEERING
UNCONTROLLED COPY
SUBJECT TO AMENDMENT
WITHOUT NOTICE
WORK ORDER
NO. 26065


Copyright © 2003 by DART AEROSPACE LTD

THIS DOCUMENT IS PRIVATE AND CONFIDENTIAL AND IS SUPPLIED ON THE EXPRESS CONDITION THAT IT IS NOT TO BE USED FOR ANY PURPOSE OR COPIED OR COMMUNICATED TO ANY OTHER PERSON WITHOUT WRITTEN PERMISSION FROM DART AEROSPACE LTD.



DESIGN JB	DRAWN BY <i>CP</i>	DART AEROSPACE LTD HAWKESBURY, ONTARIO, CANADA	
CHECKED <i>[Signature]</i>	APPROVED <i>[Signature]</i>	DRAWING NO. D3188	REV. A SHEET 6 OF 7
DATE 03.04.03		TITLE SPACEPOD BODY	SCALE NTS

03-04-28
RELEASED

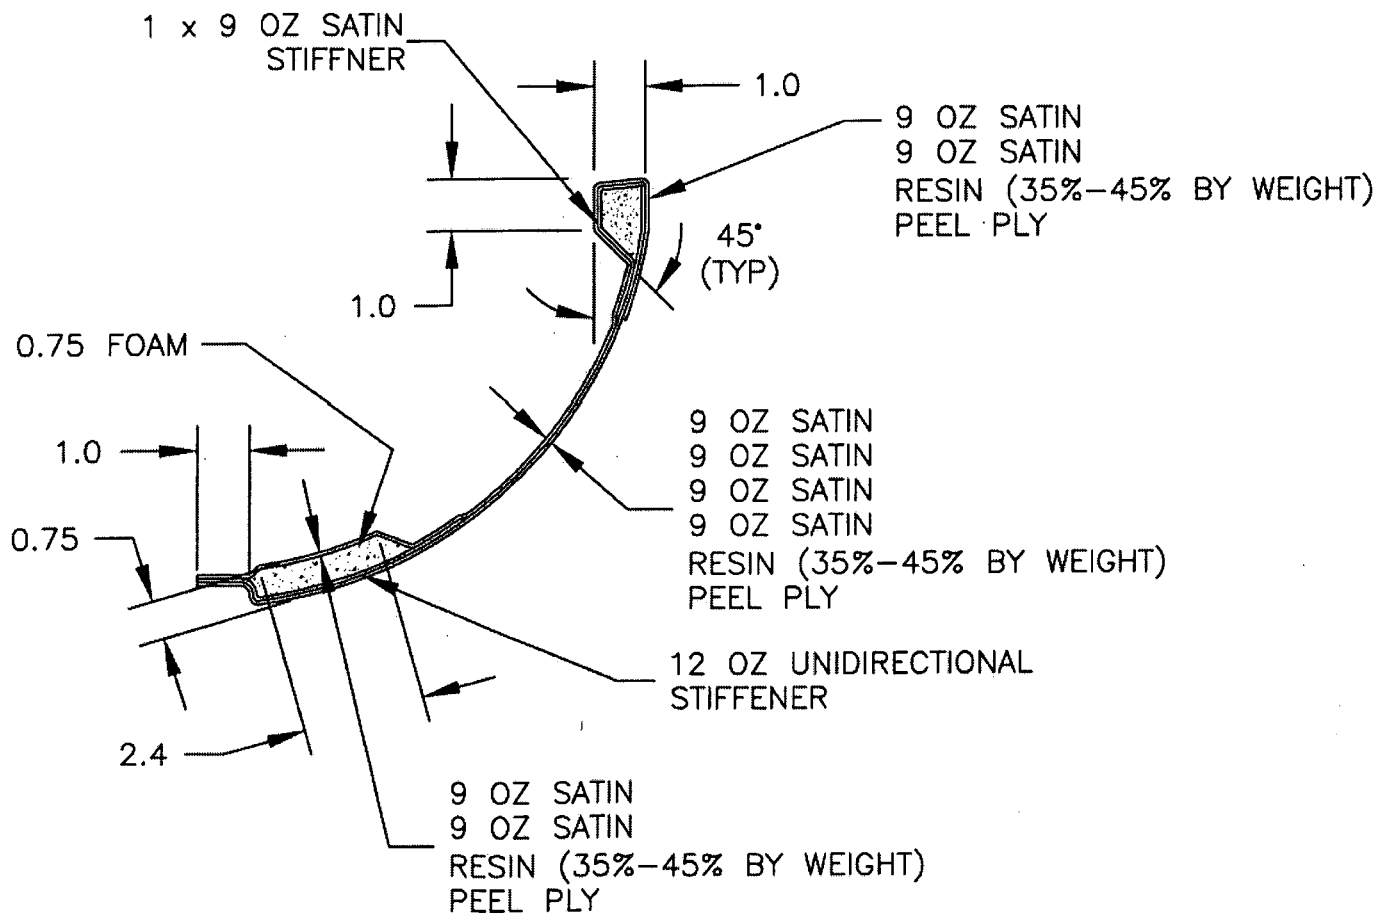

SECTION B-B
(SECTION C-C SIMILAR)

SHOP COPY
RETURN TO
ENGINEERING
UNCONTROLLED COPY
SUBJECT TO AMENDMENT
WITHOUT NOTICE
WORK ORDER
NO. 26065


Copyright © 2003 by DART AEROSPACE LTD

THIS DOCUMENT IS PRIVATE AND CONFIDENTIAL AND IS SUPPLIED ON THE EXPRESS CONDITION THAT IT IS NOT TO BE USED FOR ANY PURPOSE OR COPIED OR COMMUNICATED TO ANY OTHER PERSON WITHOUT WRITTEN PERMISSION FROM DART AEROSPACE LTD.



DESIGN JB	DRAWN BY CP	DART AEROSPACE LTD HAWKESBURY, ONTARIO, CANADA	
CHECKED #	APPROVED C	DRAWING NO. D3188	REV. A SHEET 7 OF 7
DATE 03.04.03		TITLE SPACEPOD BODY	SCALE NTS

RELEASED
#03.04.22

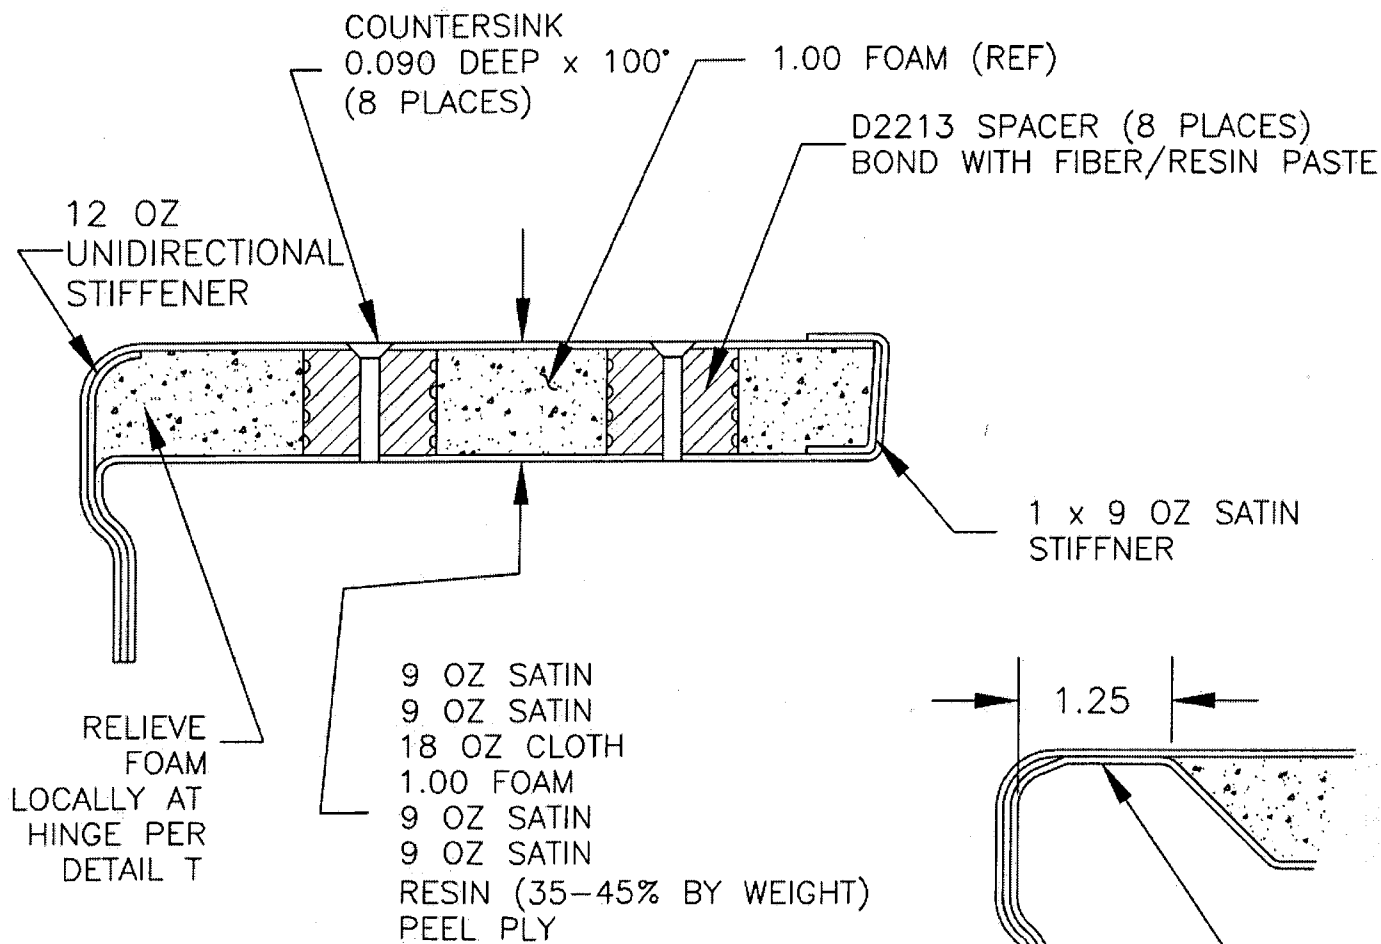

SECTION D-D
(TYPICAL ROOF SECTION)

SHOP COPY
RETURN TO
ENGINEERING
UNCONTROLLED COPY RELIEVE AS SHOWN
SUBJECT TO AMENDMENT 3" LONG CENTERED
WITHOUT NOTICE ON HINGE
WORK ORDER
NO. 26065
DETAIL T

Copyright © 2003 by DART AEROSPACE LTD

THIS DOCUMENT IS PRIVATE AND CONFIDENTIAL AND IS SUPPLIED ON THE EXPRESS CONDITION THAT IT IS NOT TO BE USED FOR ANY PURPOSE OR COPIED OR COMMUNICATED TO ANY OTHER PERSON WITHOUT WRITTEN PERMISSION FROM DART AEROSPACE LTD.

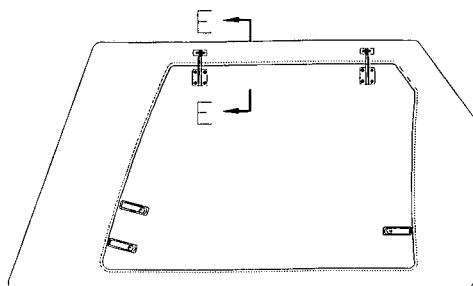


FIGURE 3. LOOKING AT OUTSIDE OF
D350-600-145 DOOR
(D350-600-146 SIMILAR AND OPPOSITE)

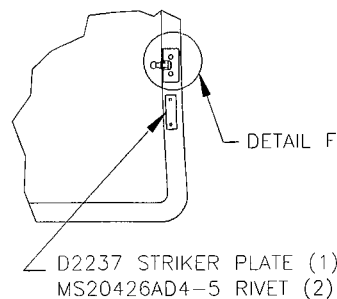


FIGURE 4. TYPICAL DOOR FRAME (AFT EDGE)


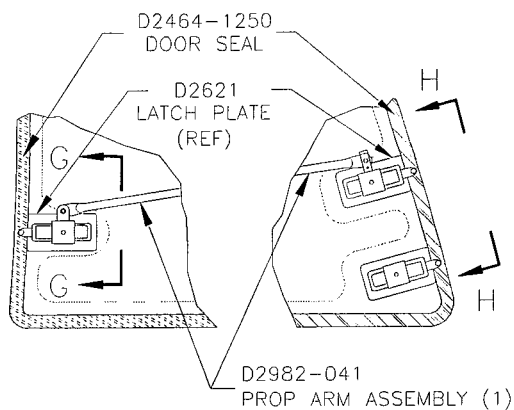


FIGURE 5. LOOKING AT TYPICAL INSIDE
OF D350-600-145/-146 DOOR

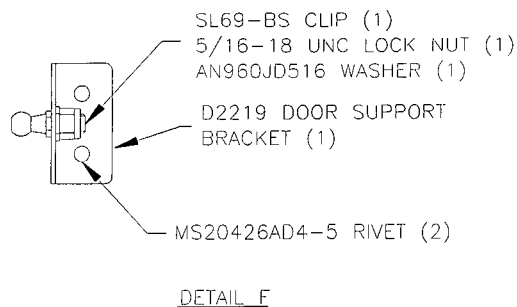

TC Accepted
MAY 07 2003


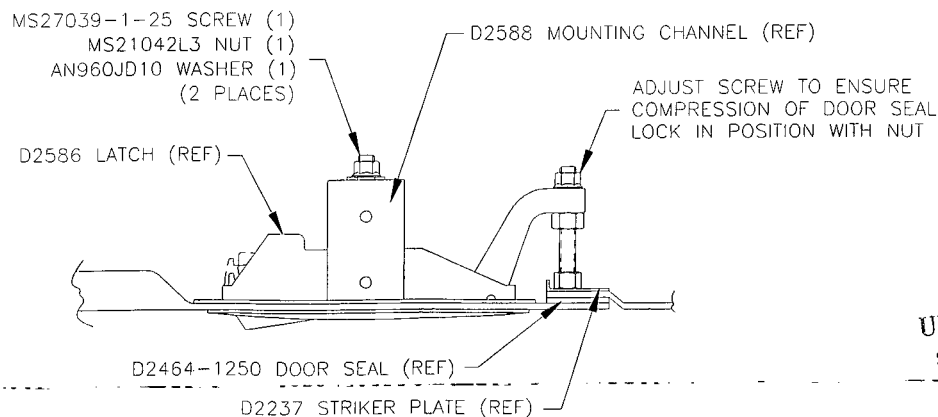



FIGURE 6. TYPICAL LATCH INSTALLATION

SHOP COPY
RETURN TO
ENGINEERING
UNCONTROLLED COPY
SUBJECT TO AMENDMENT
WITHOUT NOTICE
WORK ORDER
NO. 26065


• COPYRIGHT © 2000 BY DART AEROSPACE LTD. •
THIS DOCUMENT IS PRIVATE AND CONFIDENTIAL AND IS SUPPLIED ON THE EXPRESS CONDITION THAT IT IS NOT TO BE USED FOR ANY PURPOSE OR COPIED
OR COMMUNICATED TO ANY OTHER PERSON WITHOUT WRITTEN PERMISSION FROM DART AEROSPACE LTD.

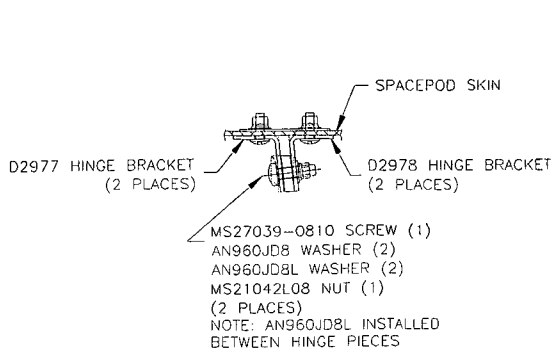


SECTION I-I: HINGE BRACKET

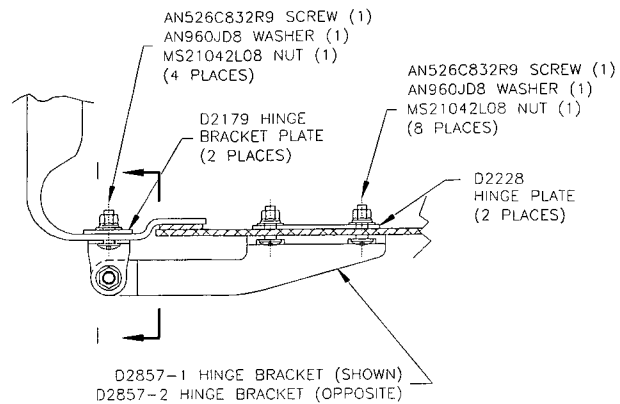

SECTION E-E: HINGE DETAIL FROM FIGURE 3

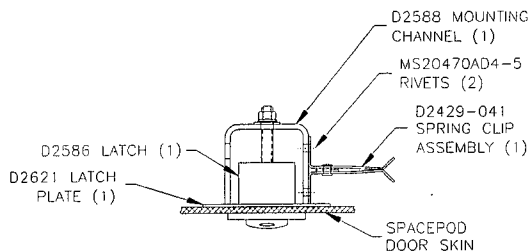

SECTION H-H: FWD LATCH

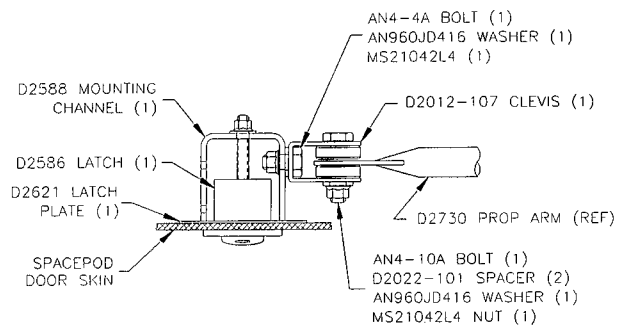

SECTION G-G: AFT LATCH

25.3 SPACEPOD™ REMOVAL

1. Remove D350-600-045/-145 or -046/-146 door.
2. Remove battery shelf and wiring covers as applicable.
3. Loosen floor and D2174-041 bracket fasteners shown in section A-A, B-B, and C-C of Figure 2. Leave inserts in the compartment floor.
4. Remove **Spacepod™** body from the compartment.
5. Remove D2174-041 brackets.
6. Re-install battery shelf and wiring covers.
7. Re-install outboard tiedown "D" rings.
8. Re-install door latch tiedown brackets in the compartment floor.
9. Re-install baggage retaining net.
10. Re-install original side baggage compartment door.

SHOP COPY
RETURN TO
ENGINEERING
UNCONTROLLED COPY
SUBJECT TO AMENDMENT
WITHOUT NOTICE
WORK ORDER
NO. 26065

TC Accepted

MAY 07 2003

• COPYRIGHT © 2000 BY DART AEROSPACE LTD. •
THIS DOCUMENT IS PRIVATE AND CONFIDENTIAL AND IS SUPPLIED ON THE EXPRESS CONDITION THAT IT IS NOT TO BE USED FOR ANY PURPOSE OR COPIED OR COMMUNICATED TO ANY OTHER PERSON WITHOUT WRITTEN PERMISSION FROM DART AEROSPACE LTD.

25-00-00

DELASTEK COMPOSITES

DELASTEK COMPOSITES INC.
2699, Sième Avenue
Local 14, PORTE -A-
Grand-Mère, Québec G9T 5K7
Can **Fax (819) 533-3494 **

PACKING SLIP CERTIFICATE OF COMPLIANCE

Invoice #	10680
Customer #	DART

Telephone: (819) 533-5788
Warehouse: MAIN

Bill to:

Dart Aerospace Ltd.
1270, Aberdeen Street
Hawkesbury, Ontario K6A 1K7
Canada

Ship to:

Dart Aerospace Ltd.
1270, Aberdeen Street
Hawkesbury, Ontario K6A 1K7
Canada

Telephone: 613-632-3336
Contact: Linda Lacelle

Ship via		F.O.B.		Terms		Salesperson	
EPIC EXPRESS COLLECT		Point de départ		Net30 days		Claude Lessard, ext. 233	
Ship date	Order Date	Our PO #	Order by	Your PO #	GST/PST #		
03/07/06	07/03/06	4469	Linda Lacelle	PO00000745			
Order Qty	B.O. Qty	Carton Ship	Item #	Item Description			
1	0	1	DKC134-0020	D3188-2 Spacepod Body RH B26065 B26065 JOB: 33759 QTÉ: 1			
1	0	1	DKC134-0018	D3186-2 Spacepod Door RH B26065 B26065 JOB: 33756 QTÉ: 1			

It is hereby certified that all materials, process and finished items were controlled and tested in accordance with the requirements of the purchase order and applicable specifications. All such records are on file at our plant and available for review upon request.

☐ Cust. ☐ Adm. ☐ Quality ☐ Ship.

Accepted by:

Quality department

AQ-357